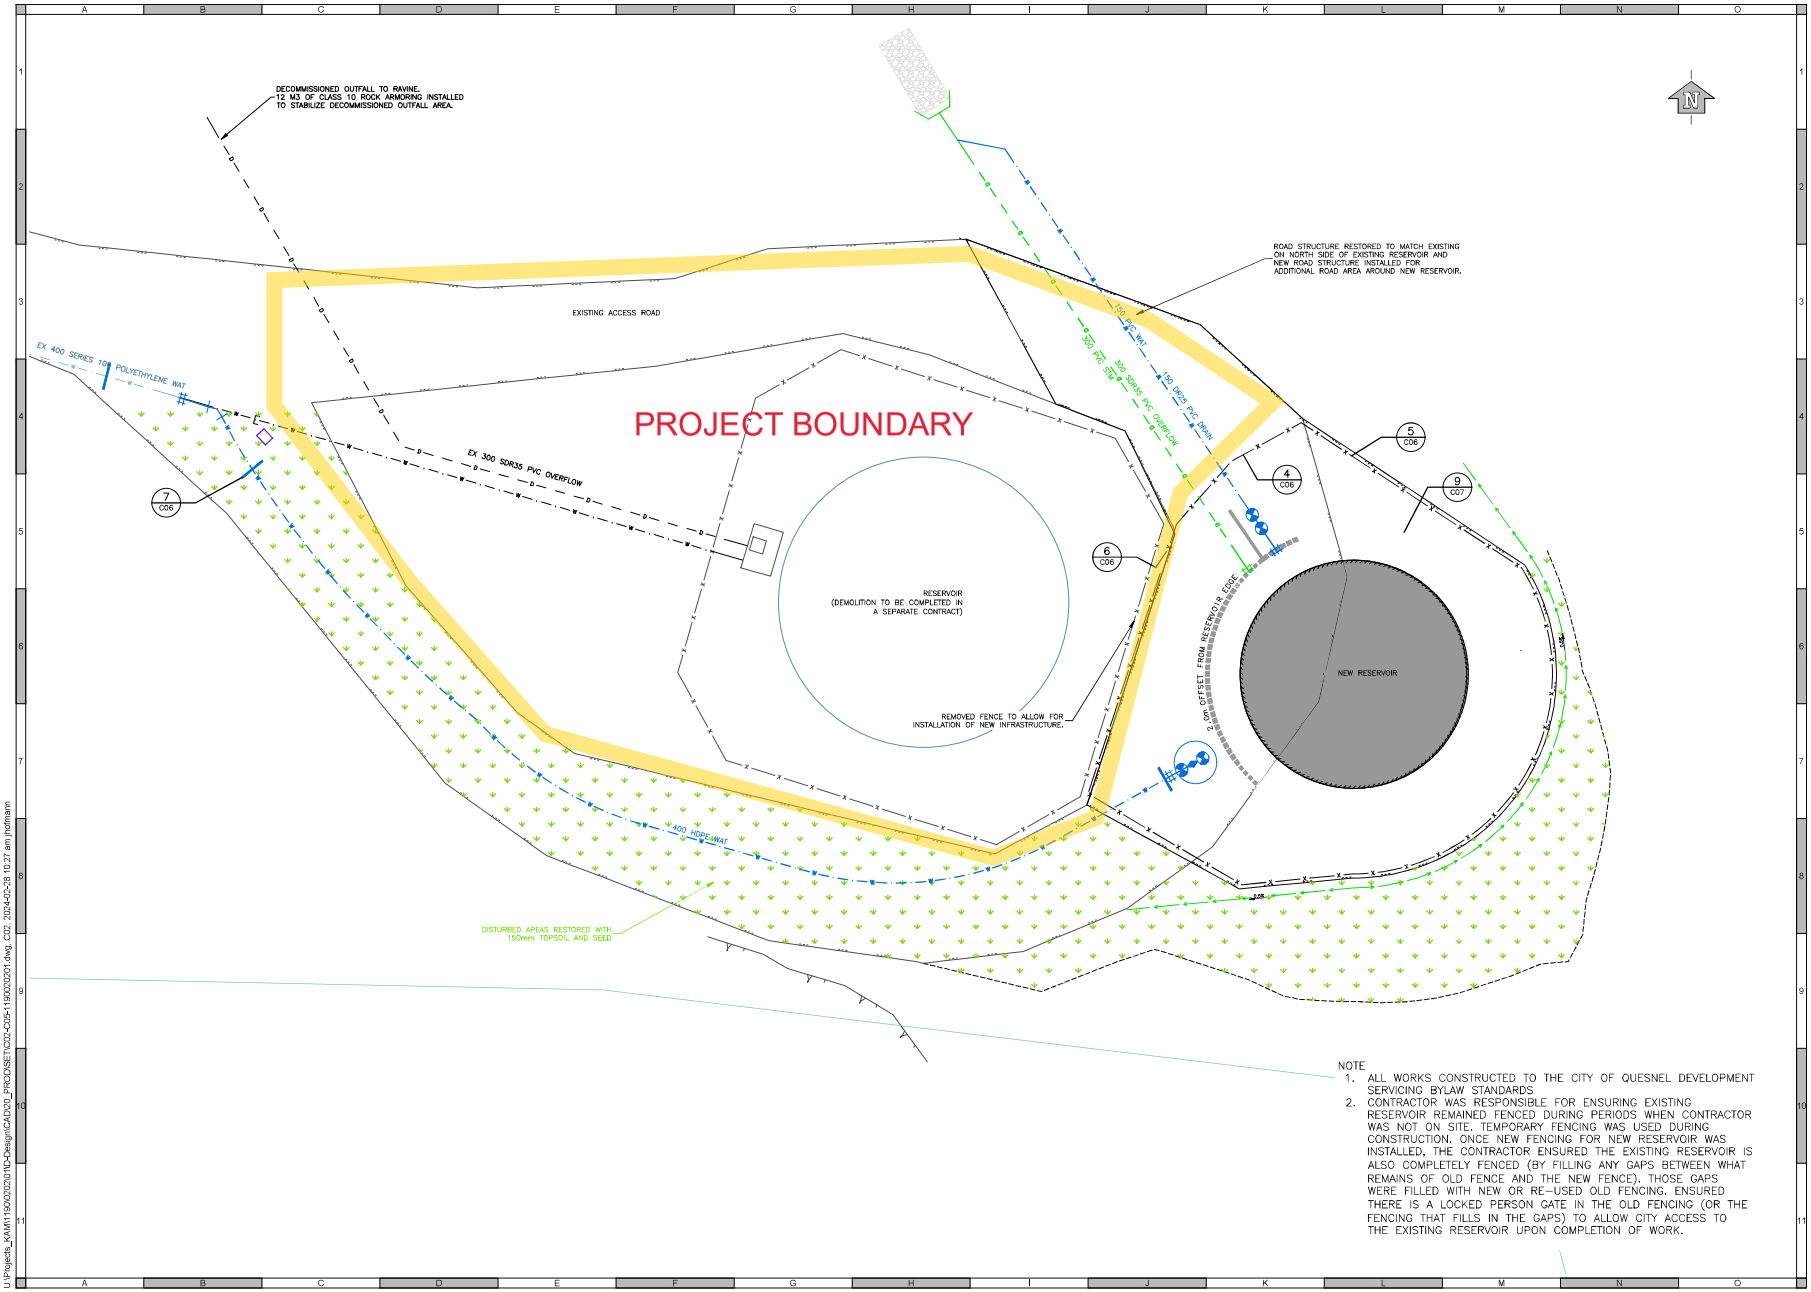

NOTE
1. ALL WORKS CONSTRUCTED TO THE CITY OF QUESNEL DEVELOPMENT SERVICING BYLAW STANDARDS
2. CONTRACTOR WAS RESPONSIBLE FOR ENSURING EXISTING RESERVOIR REMAINED FENCED DURING PERIODS WHEN CONTRACTOR WAS NOT ON SITE. TEMPORARY FENCING WAS USED DURING CONSTRUCTION. ONCE NEW FENCING FOR NEW RESERVOIR WAS INSTALLED, THE CONTRACTOR ENSURED THE EXISTING RESERVOIR IS ALSO COMPLETELY FENCED (BY FILLING ANY GAPS BETWEEN WHAT REMAINS OF OLD FENCE AND THE NEW FENCE). THOSE GAPS WERE FILLED WITH NEW OR RE-USED OLD FENCING. ENSURED THERE IS A LOCKED PERSON GATE IN THE OLD FENCING (OR THE FENCING THAT FILLS IN THE GAPS) TO ALLOW CITY ACCESS TO THE EXISTING RESERVOIR UPON COMPLETION OF WORK.

ATTENTION
This drawing is prepared for the sole use of
CITY OF QUESNEL
No representations of any kind are made by Urban Systems Ltd. or its employees to any party with whom Urban Systems Ltd. does not have a contract.

WARNING
Utilities or structures shown on this drawing were compiled from information supplied by various parties and may not be complete or accurate. Expose and conclusively confirm the location in the field all underground utilities and structures indicated on this drawing, all underground utilities in the area of the proposed work and any utilities or structures reasonably apparent from an inspection of the proposed work. Urban Systems Ltd. assumes no responsibility for loss or damage caused by third party negligence or failure to comply with the above.

DISCLAIMER
The seal and signature of the undersigned on this drawing certifies that the design information contained in these drawings accurately reflects the original design and the material design changes made during construction, that were brought to the undersigned's attention. These drawings are intended to incorporate addenda, change orders and other material design changes, but not necessarily all site instructions. The undersigned does not warrant or guarantee, nor accept any responsibility for the accuracy or completeness of information supplied by others contained in these drawings, but does, by sealing and signing, certify that the information, if accurate and complete, provides a system which substantially complies in all material respects with the original design intent.

ISSUED FOR
RECORD
FEBRUARY 28, 2024
urbansystems.ca

Professional Seals

#	Date	Issue / Revision	App
A	2022-04-20	Issued For Review	RC
B	2022-04-27	Issued for Tender	RC
C	2022-04-27	Issued for Northern Health Approval	RC
1	2022-06-03	Issued for Construction	RC
2	2023-12-21	Issued for Record	RC

URBAN systems

Scale 1:5m 0 1 2 3 4 5

Quality Control by R.COLLINS
Designed by R. D'AMOURS
Drawn by R. THOMSON

DRAGON HILL RESERVOIR REPLACEMENT
SITE PLAN

Sheet Number 2 of 7

Project Number	Drawing Number	Revision
1190.0202.01	C02	2

U:\Projects_KAM\1190\0202\01\ND-Design\CAD\00_PROD\SET\C02-C07-1190020201.dwg, C02, 2024-02-28 10:27 am jhofmann